
FLOOR 03


135 MICHAEL COWPLAND DRIVE, OTTAWA, ON
(AS-BUILT FLOOR PLAN)

0 5 10 15 20 FEET
0 1.52 3.05 4.57 6.10 METRES

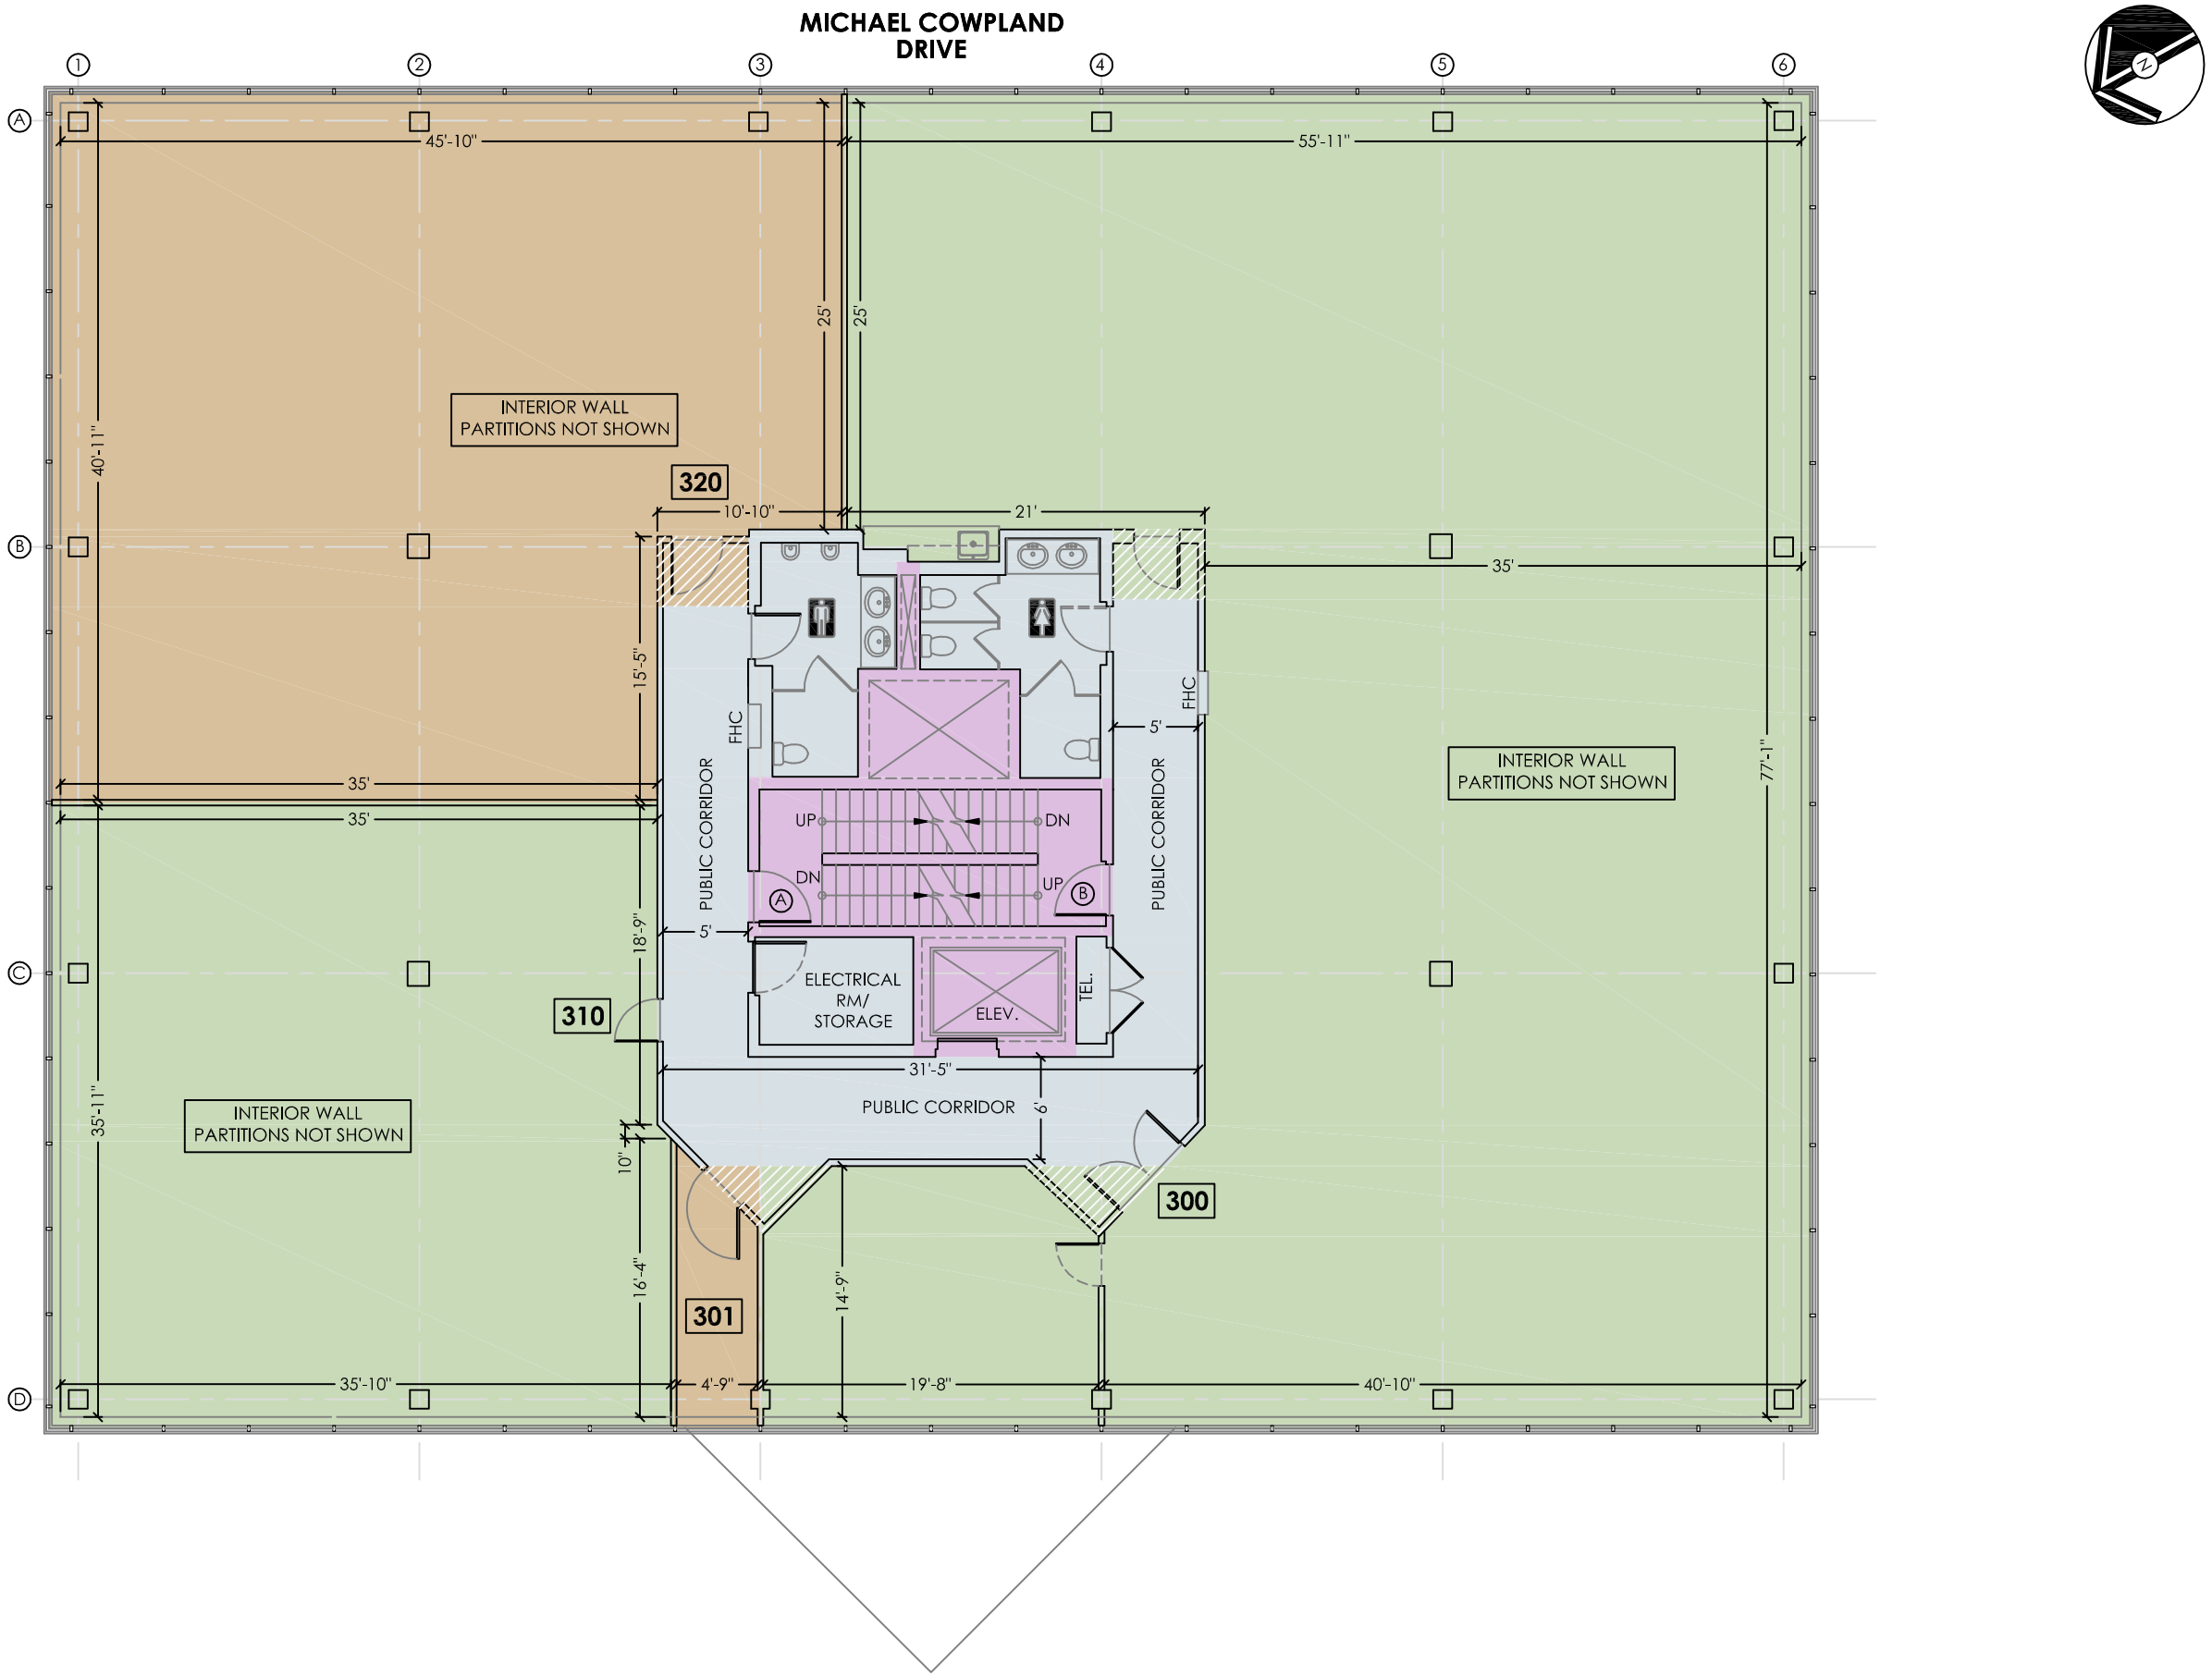



AERIAL VIEW

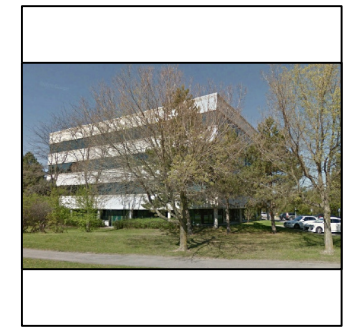

EXTERIOR VIEW

LEGEND:

- EXISTING WALLS
- DW DISH WASHER
- ELEC ELECTRICAL
- EP ELECTRICAL PANEL
- FCP FIRE CONTROL PANEL
- FHC FIRE HOSE CABINET
- HW HOT WATER TANK
- T TRANSFORMER
- TEL TELECOMMUNICATIONS

SHADING LEGEND:

- MAJOR VERTICAL PENETRATION
- OCCUPANT AREA #1
- OCCUPANT AREA #2
- OCCUPANT AREA/ EXTENDED CIRCULATION
- BUILDING SERVICE AREA
- FLOOR SERVICE & AMENITY AREA
- OCCUPANT STORAGE AREA
- BUILDING AMENITY AREA
- PARKING

PREPARED FOR: Andash Property Management
ADDRESS: 135 Michael Cowpland Dr., Kanata, ON
DATE: May 31, 2017
REVISION: n/a
PROJECT NUMBER: 200196
DRAWING SCALE: 11" x 17" - Tabloid Size

NOTE: ORIGINAL AS-BUILT INFORMATION PROVIDED BY ECHO FLOOR PLANS

PREPARED BY: ECHO3GROUP.COM